

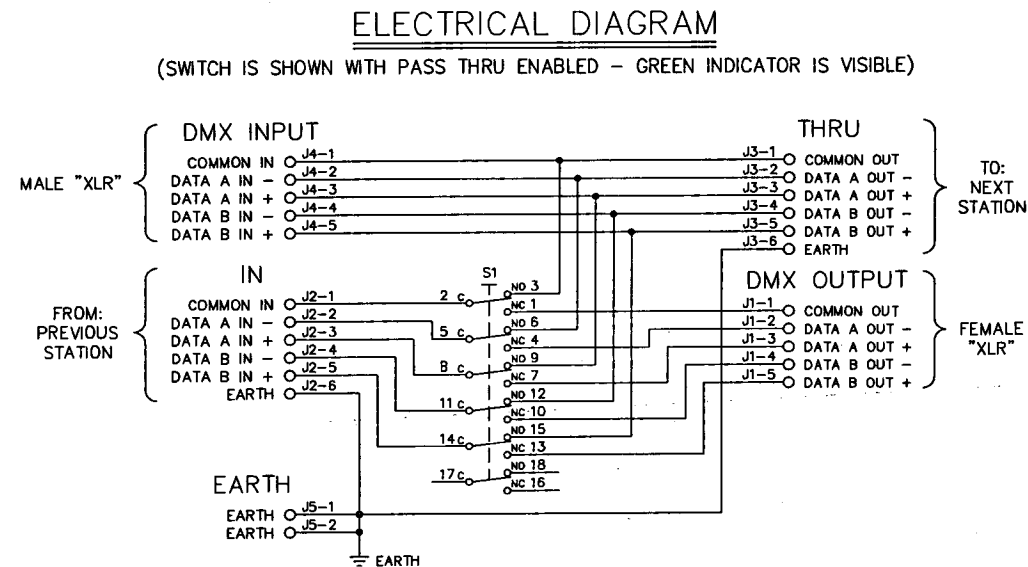
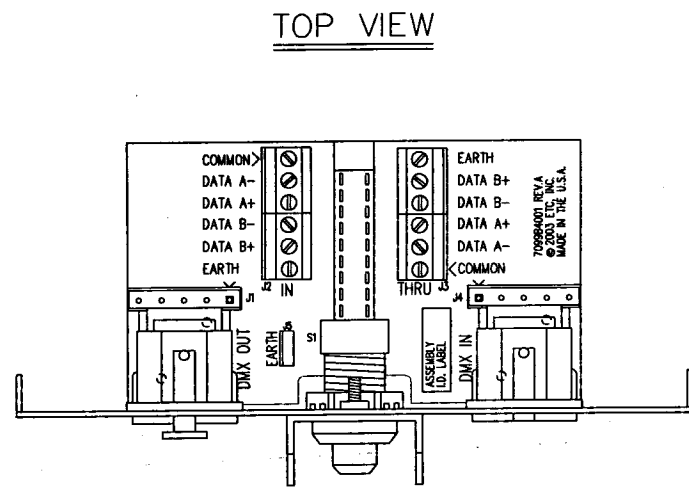
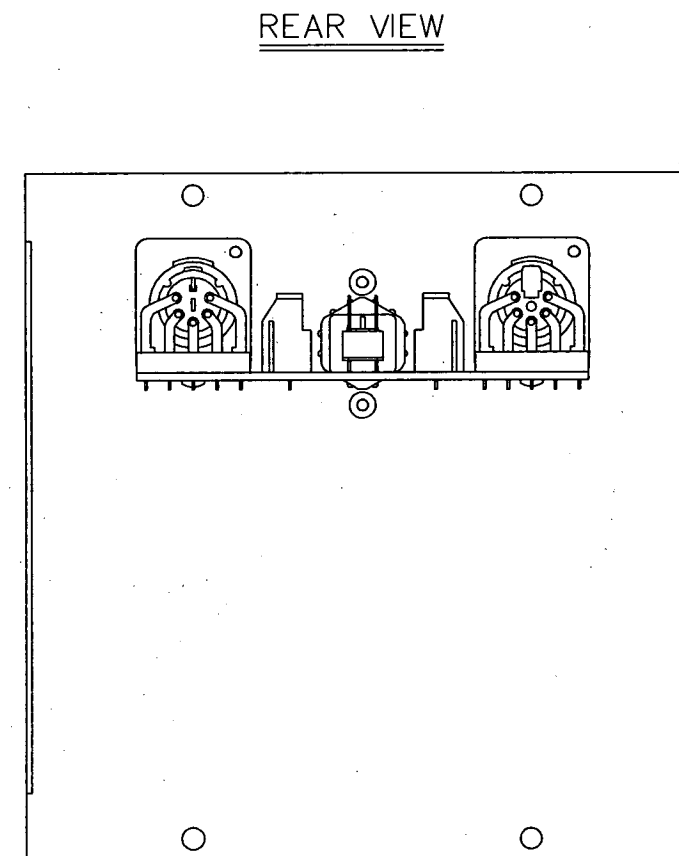


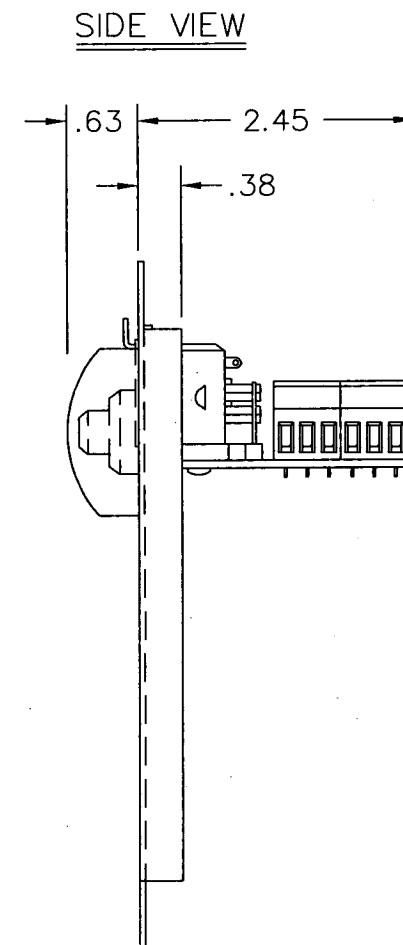

NOTES:

- 1.) PANEL IS CONSTRUCTED OF 18 GA. (.048) STEEL AND IS FINISHED IN A BLACK FINE-TEXTURED POWDER COAT.
- 2.) SWITCH "GUARD" IS CONSTRUCTED OF 16 GA. (.06) STEEL AND IS FINISHED IN A BLACK FINE-TEXTURED POWDER COAT.
- 3.) ALL NOMENCLATURE IS REVERSE-SILKSCREENED ONTO A VELVET LEXAN ADHESIVE LABEL; WHITE TEXT - BLACK BACKGROUND.

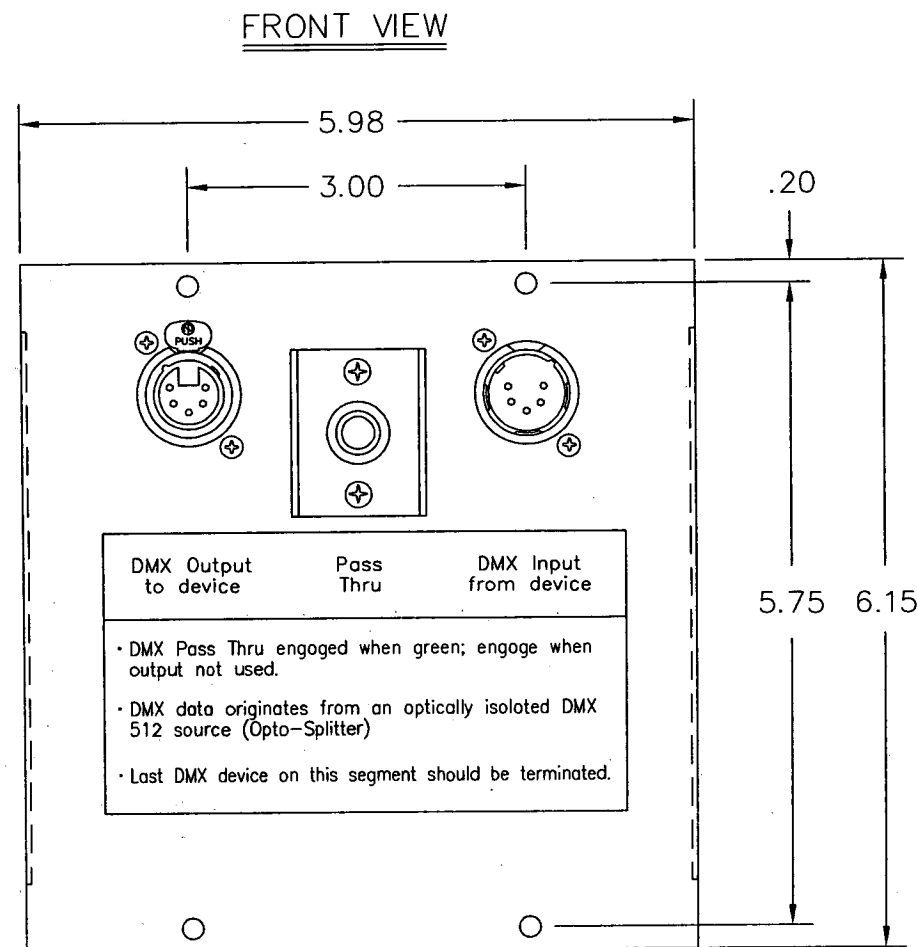


ITEM	QTY.	DESCRIPTION	DESIGNATION	PART NUMBER
1	3	DMX IN-AND-THRU PANEL ASSEMBLY	(INSTALLED ON STRIP)	7099A2013

PARTS LIST

Electronic Theatre Controls Inc

3031 Pleasant View Rd
PO Box 620979
Middleton WI 53562 0979
Tel 608 831 4116
Toll Free 800 688 4116
Fax 608 836 1736
www.etcconnect.com

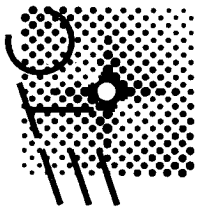

UNLESS OTHERWISE SPECIFIED - ALL DIMENSIONS ARE IN INCHES.

JOB:	VAIL SCHOOL DISTRICT AUDITORIUM	FILE NAME:	9900 DMX IN-OUT.DWG
LOCATION:	TUCSON, ARIZONA		
CONTRACT WITH:	SECOA		
REPRESENTATIVE:	RC LURE COMPANY, INC.		
TITLE:	"DMX-IN-AND-THRU" DATA PANEL		
REV.	A		
DRAWING:	15006133-22A		
AS-BUILT			
SUBMITTAL			
DWG. STATUS			
DATE	9/21/07		
BY	DGB		
APPD.			